

# JOSH'S HOUSE


LANDSCAPING DESIGN

07/08/2013

## DRAWING SHEET LIST


- LC-001 LANDSCAPING DESIGN - COVER PAGE & OVERALL PLAN
- LC-002 LANDSCAPING DESIGN - LEGEND
- LC-101 LANDSCAPING DESIGN - HARD WORKS PLAN - UNIT 1
- LC-102 LANDSCAPING DESIGN - HARD WORKS PLAN - UNIT 2
- LC-201 LANDSCAPING DESIGN - SOFT WORKS PLAN - UNIT 1
- LC-202 LANDSCAPING DESIGN - SOFT WORKS PLAN - UNIT 2

**SCHEMATIC DESIGN ONLY**  
REFER TO GENERAL NOTES, COMPLIANCE  
& INSTALLATION INSTRUCTIONS.

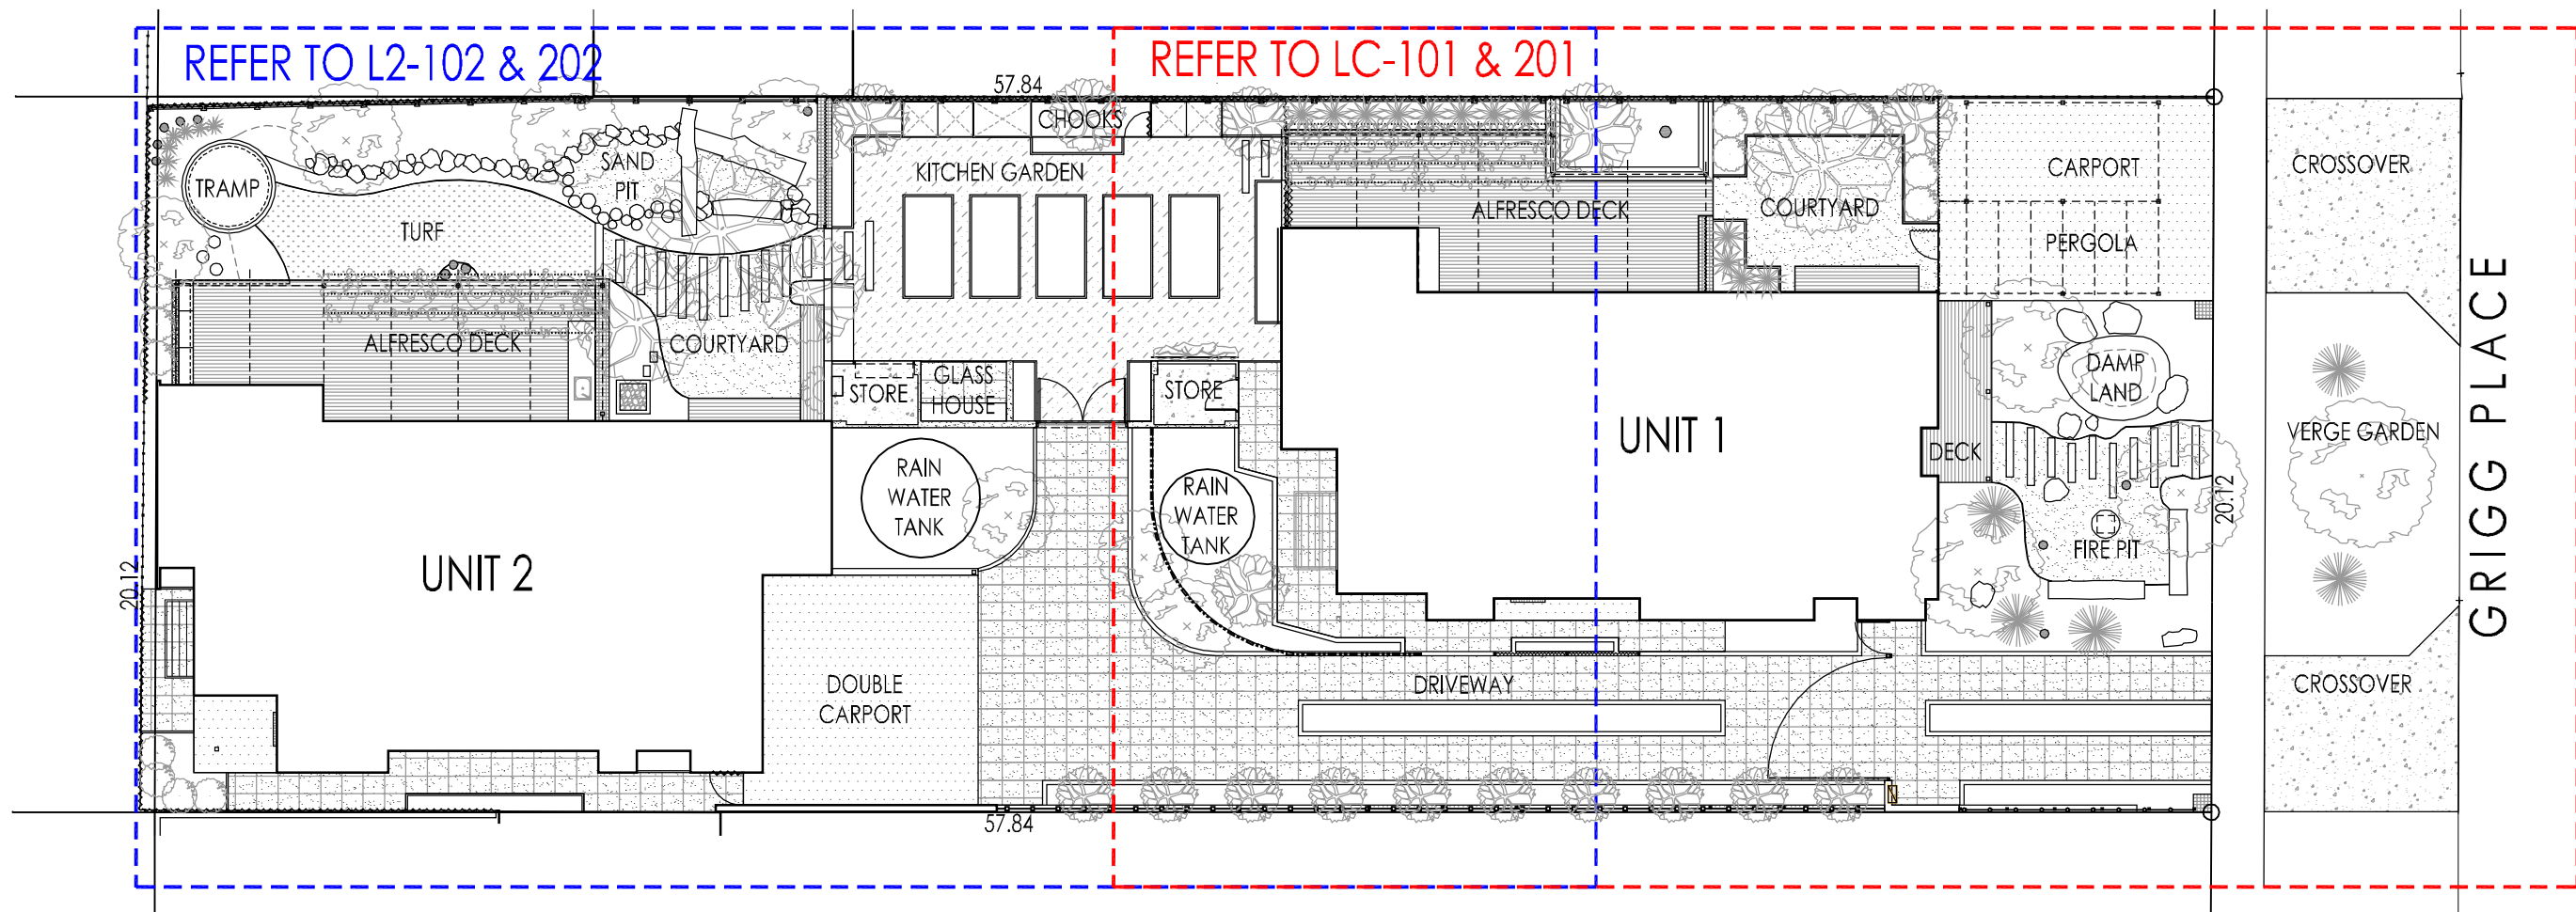


07/08/2013	AS CONSTRUCTED ISSUE	--
DATE	DESCRIPTION	REV

NOTE: CHECK ALL DIMENSIONS ON SITE PRIOR TO COMMENCING WORK. WRITTEN DIMENSIONS SHALL TAKE PRECEDENCE. ALL DRAWINGS TO BE READ IN CONJUNCTION WITH MANUFACTURERS AND CONSULTANTS DOCUMENTATION AND SPECIFICATION. REPORT ANY DISCREPANCIES TO LANDSCAPE DESIGNER BEFORE PROCEEDING WITH WORK.  
COPYRIGHT ©: THIS DOCUMENT HAS BEEN PREPARED FOR USE BY THE RECEIVING CLIENT ONLY. ALL CONCEPTS, DRAWINGS AND TECHNICAL INFORMATION REMAIN THE PROPERTY OF JOSH BYRNE & ASSOCIATES PTY LTD. THIS DOCUMENT CANNOT BE REPRODUCED OR DISTRIBUTED FOR ANY PURPOSE OTHER THAN FOR CONSTRUCTION PURPOSES OF THE SITE DESCRIBED.

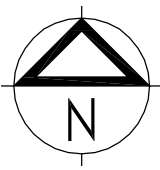

**AS CONSTRUCTED**

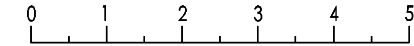

PROJECT TITLE  
**JOSH'S HOUSE**

DRAWING TITLE  
LANDSCAPING DESIGN - CONTENTS PAGE & OVERALL PLAN

PROJECT NO. D-00-3	SCALE 1:200	SHEET 1 of 6	REVISION --
CAD FILE PATH -		PRINT DATE 07/08/2013	
DRAWN AB	CHECKED JB	APPROVED JB	DWG NO. LC-001


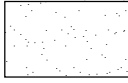

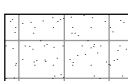
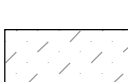
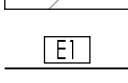

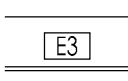
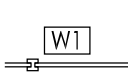
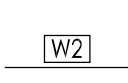
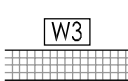
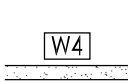
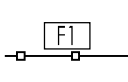
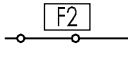



**JOSH BYRNE & ASSOCIATES**  
Environment • Design • Communication  
phone 08 9433 3721 fax 08 9433 3728  
suite 10, 16 phillimore street fremantle wa 6160  
po box 1866, fremantle wa 6959  
www.joshbyrne.com.au  
jba@joshbyrne.com.au



# GENERAL NOTES

## GENERAL







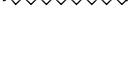

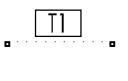

- DRAWINGS TO BE READ IN CONJUNCTION WITH ALL OTHER PROJECT, ARCHITECT, ENGINEERS & MANUFACTURERS DOCUMENTATION
- ALL SERVICE LINE WORK & ARRANGEMENTS ARE INDICATIVE ONLY
- PRODUCTS TO BE INSTALLED IN ACCORDANCE WITH MANUFACTURER'S SPECIFICATIONS
- CONFIRM ALL DIMENSIONS ON SITE
- CONFIRM LOCATION & ROUTING OF ALL SERVICES ON SITE
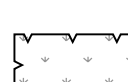
# HARD WORKS LEGEND

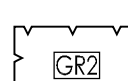-  PAVING TYPE 1 - 100mm THICK REINFORCED CONCRETE IN-SITU PAVING, ON COMPACTED SUB GRADE
-  PAVING TYPE 2 - 100mm THICK REINFORCED EXPOSED AGGREGATE CONCRETE PAVING ON COMPACTED SUB GRADE
-  PAVING TYPE 3 - 75mm THICK SELECTED COARSE GRAVEL WITH GEOTEXTILE FABRIC BELOW
-  PAVING TYPE 4 - 600x500x30mm DEEP 'NEROCELL' DRAINAGE SYSTEM, WITH SELECTED GRAVEL INFILL WITH 50mm TOP COVER, GEOTEXTILE FABRIC BELOW
-  PAVING TYPE 5 - 75mm DEEP FINE GRADE PINE BARK MULCH ON LIGHTLY COMPACTED SUB GRADE
-  EDGING TYPE 1 - 150mm SALVAGED REINFORCED RUBBER GARDEN EDGING. GENERALLY TOP OF EDGING TO FINISH FLUSH WITH FINISHED SURFACE LEVEL.
-  EDGING TYPE 2 - 120mm WIDE CONCRETE FLUSH KERBING
-  EDGING TYPE 3 - 180x50mm SALVAGED JARRAH GARDEN BED EDGING, TO FINISH 120mm ABOVE FINISHED GROUND LEVEL
-  WALL TYPE 1 - TYPICALLY 900mm HIGH PRECAST CONCRETE POST & RAIL RETAINING WALL SYSTEM
-  WALL TYPE 2 - 230mm THICK DOUBLE FACE BRICK WALL, ON CONCRETE FOOTING. RESTORATION RED STYLE BRICK
-  WALL TYPE 3 - 400mm THICK WELD MESH GABION BOX WALL WITH SELECTED LIMESTONE SPALL INFILL, ON CONCRETE FOOTING
-  WALL TYPE 4 - 190mm THICK DOUBLE BRICK WALL WITH RENDERED FINISH, ON CONCRETE FOOTING
-  FENCE TYPE 1 - 1800mm HIGH METAL FENCING WITH 50SHS POSTS
-  FENCE TYPE 2 - 1000mm HIGH GALV 50SHS FRAMED FENCE WITH 70x20mm HORIZONTAL JARRAH BATTENS SCREEN WITH 40mm GAPS
-  SCREEN TYPE 1 - TRELLIS TOP SCREEN - 70x20mm HORIZONTAL JARRAH BATTEN SCREEN WITH GALV 50SHS POSTS @ MAX 1050mm CTS. NOMINALLY 10 BATTENS TO TOP WITH 40mm GAPS
-  SCREEN TYPE 2 - OPEN SCREEN - 70x20mm HORIZONTAL JARRAH BATTEN SCREENS WITH GALV 50SHS POSTS @ MAX 1050mm CTS. FULL HEIGHT SCREEN, WITH 40mm GAPS
-  SCREEN TYPE 3 - CLOSED SCREEN - 70x20mm HORIZONTAL JARRAH BATTEN SCREENS FIXED TO BOTH SIDES OF GALV 50SHS POSTS @ MAX 1050mm CTS. FULL HEIGHT SCREEN, WITH 40mm GAPS ON BOTH SIDES, OFFSET TO OBSCURE VIEWS THROUGH SCREEN

-  TRELLIS TYPE 1 - 1800mm HIGH HORIZONTAL STAINLESS STEEL WIRE TRELLIS, SUPPORTED OF 50SHS POSTS IN FENCING
-  BOULDER - LIMESTONE BOULDERS. SIZES VARY

# SOFT WORKS LEGEND

-  TURF - 'DISCOVERY COUCH' WITH ROTARY SPRINKLER IRRIGATION, INSTALLED ON EXISTING SELECTED FREE DRAINING SAND, WITH 30mm SOIL CONDITIONER & FERTILISER EVENLY MIXED TO 50mm & EVENLY COMPACTED
-  GARDEN TYPE 1 - RAISED VEGETABLE PLANTING BED WITH DRIP IRRIGATION. 75mm THICK LUPIN MULCH, SOIL IMPROVED WITH 75mm SOIL CONDITIONER, MIXED TO A DEPTH OF 400mm
-  GARDEN TYPE 2 - PLANTING BED WITH DRIP IRRIGATION. 75mm THICK PINE BARK MULCH, SOIL IMPROVED WITH 50mm SOIL CONDITIONER & 300mm OF LANDSCAPE MIX, MIXED TO A DEPTH OF 400mm
-  GARDEN TYPE 3 - PLANTING BED WITH DRIP IRRIGATION. 75mm THICK LUPIN MULCH, SOIL IMPROVED WITH 50mm SOIL CONDITIONER, MIXED TO A DEPTH OF 600mm
-  GARDEN TYPE 4 - NATIVE PLANTING BED WITH DRIP IRRIGATION. 75mm THICK PINE BARK MULCH, SOIL IMPROVED WITH 50mm SOIL CONDITIONER, MIXED TO A DEPTH OF 600mm
-  EVERGREEN TREE
-  DECIDUOUS TREE
-  TRANSPLANTED GRASS TREE
-  SHRUB
-  SHRUB - TALL GRASSES

07/08/2013	AS CONSTRUCTED ISSUE	--
DATE	DESCRIPTION	REV

**NOTE:** CHECK ALL DIMENSIONS ON SITE PRIOR TO COMMENCING WORK. WRITTEN DIMENSIONS SHALL TAKE PRECEDENCE. ALL DRAWINGS TO BE READ IN CONJUNCTION WITH MANUFACTURERS AND CONSULTANTS DOCUMENTATION AND SPECIFICATION. REPORT ANY DISCREPANCIES TO LANDSCAPE DESIGNER BEFORE PROCEEDING WITH WORK.  
**COPYRIGHT ©:** THIS DOCUMENT HAS BEEN PREPARED FOR USE BY THE RECEIVING CLIENT ONLY. ALL CONCEPTS, DRAWINGS AND TECHNICAL INFORMATION REMAIN THE PROPERTY OF JOSH BYRNE & ASSOCIATES PTY LTD. THIS DOCUMENT CANNOT BE REPRODUCED OR DISTRIBUTED FOR ANY PURPOSE OTHER THAN FOR CONSTRUCTION PURPOSES OF THE SITE DESCRIBED.

PROJECT TITLE  
**JOSH'S HOUSE**

DRAWING TITLE  
LANDSCAPING DESIGN - LEGEND

PROJECT NO.  
D-00-3

SCALE  
AS SHOWN

SHEET  
2 of 6

REVISION  
--

CAD FILE PATH  
-


PRINT DATE  
07/08/2013

DRAWN  
AB

CHECKED  
JB


APPROVED  
JB



DWG NO.  
LC-002

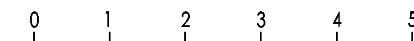

**AS CONSTRUCTED**

**JOSH BYRNE & ASSOCIATES**  
 Environment • Design • Communication  
 phone 08 9433 3721 fax 08 9433 3728  
 suite 10, 16 phillimore street fremantle wa 6160  
 po box 1866, fremantle wa 6959  
 www.joshbyrne.com.au  
 jba@joshbyrne.com.au

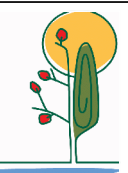


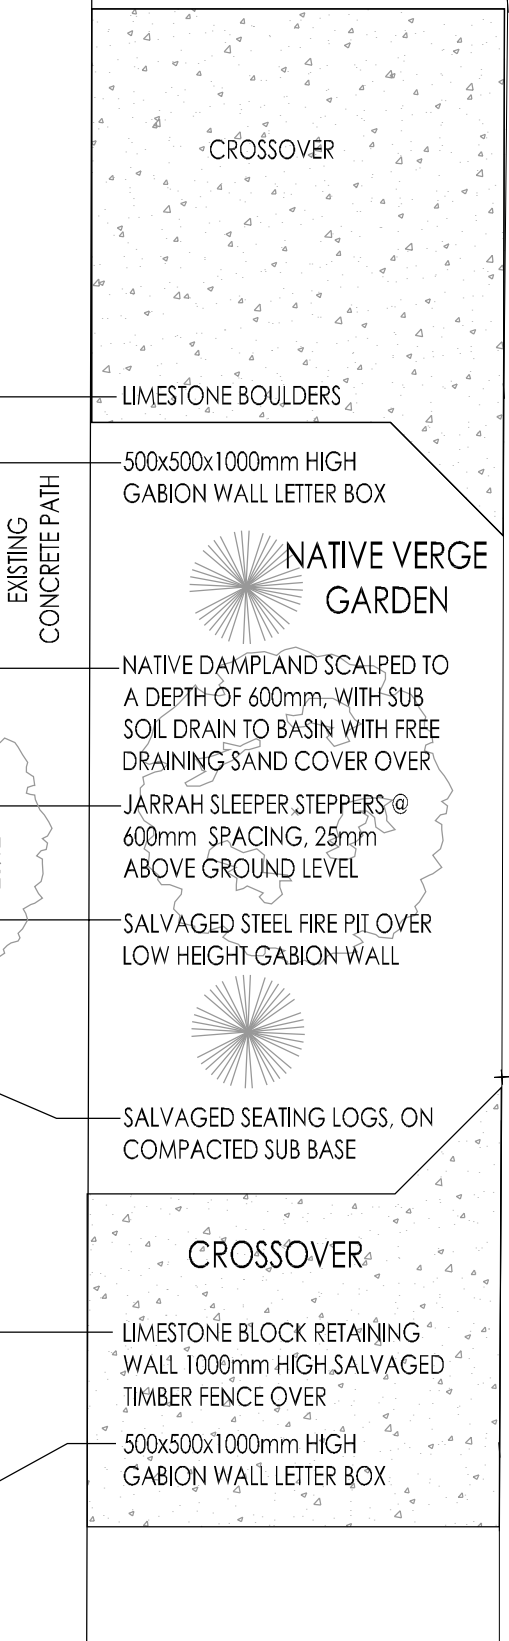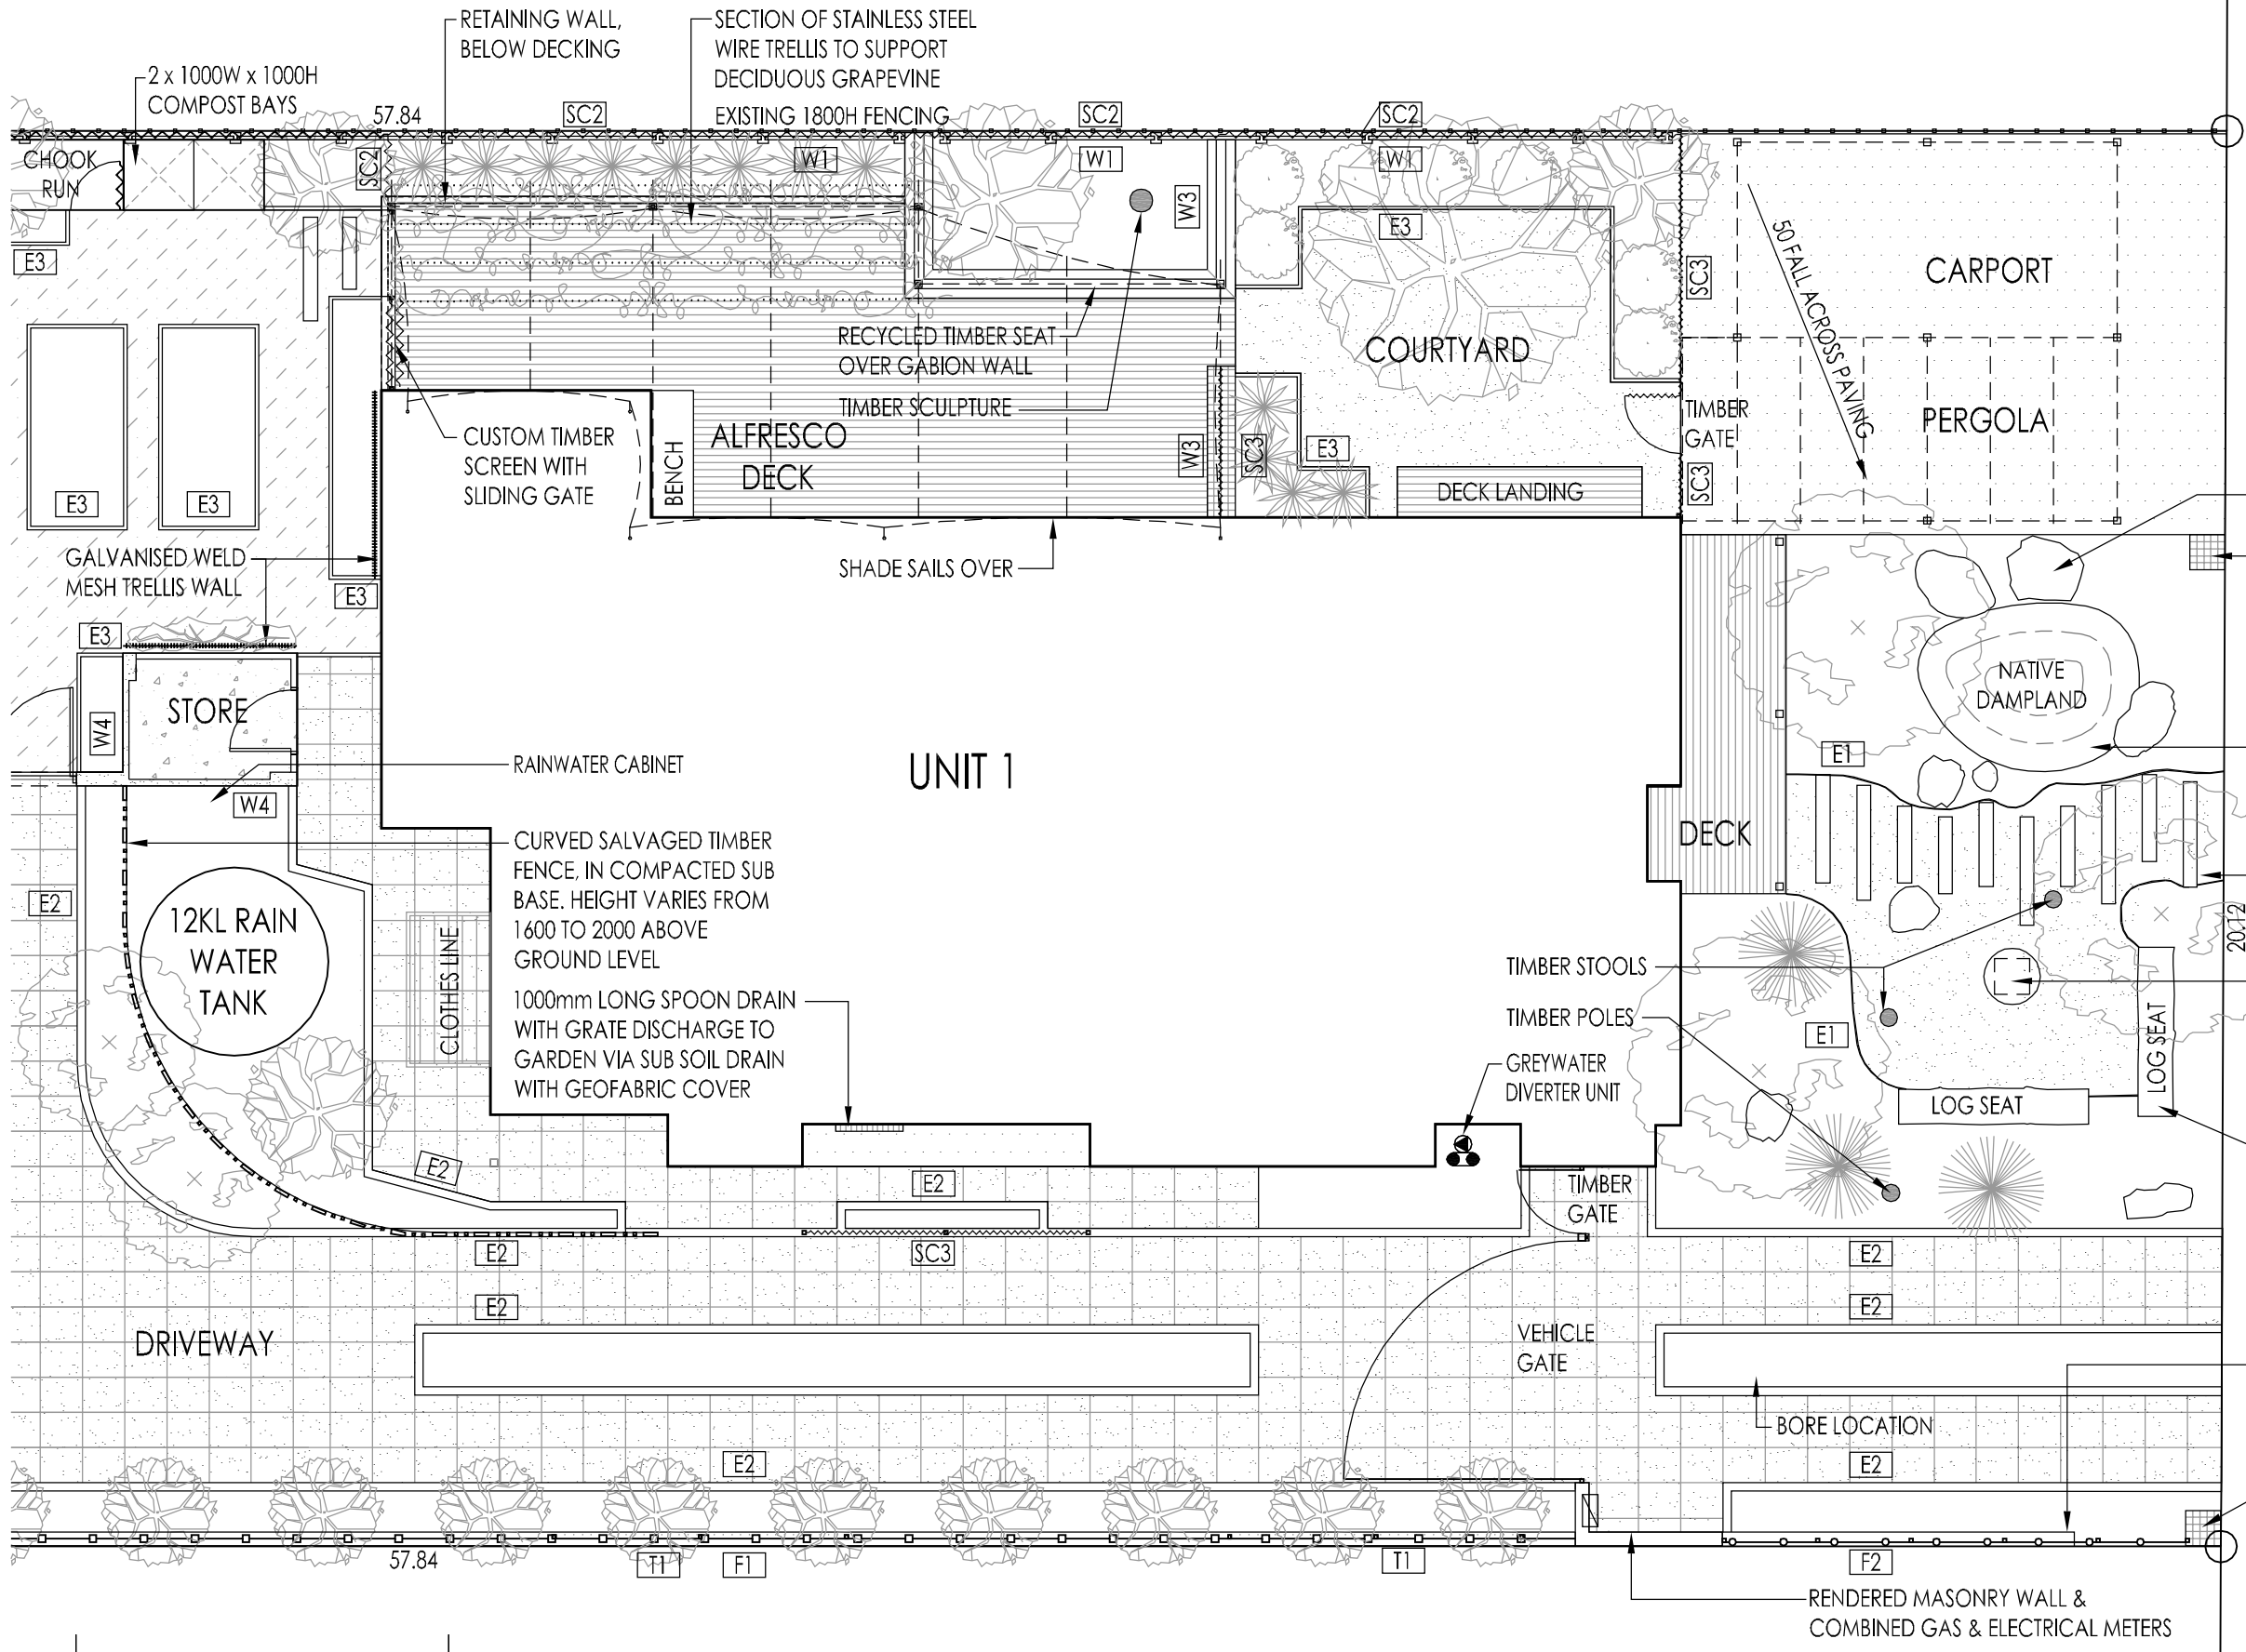


GRIGG PLACE

07/08/2013	AS CONSTRUCTED ISSUE	--
DATE	DESCRIPTION	REV

**NOTE:** CHECK ALL DIMENSIONS ON SITE PRIOR TO COMMENCING WORK. WRITTEN DIMENSIONS SHALL TAKE PRECEDENCE. ALL DRAWINGS TO BE READ IN CONJUNCTION WITH MANUFACTURERS AND CONSULTANTS DOCUMENTATION AND SPECIFICATION. REPORT ANY DISCREPANCIES TO LANDSCAPE DESIGNER BEFORE PROCEEDING WITH WORK.  
**COPYRIGHT ©:** THIS DOCUMENT HAS BEEN PREPARED FOR USE BY THE RECEIVING CLIENT ONLY. ALL CONCEPTS, DRAWINGS AND TECHNICAL INFORMATION REMAIN THE PROPERTY OF JOSH BYRNE & ASSOCIATES PTY LTD. THIS DOCUMENT CANNOT BE REPRODUCED OR DISTRIBUTED FOR ANY PURPOSE OTHER THAN FOR CONSTRUCTION PURPOSES OF THE SITE DESCRIBED.

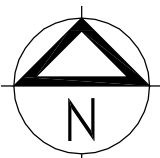



## AS CONSTRUCTED

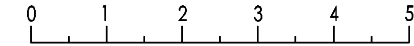

PROJECT TITLE <b>JOSH'S HOUSE</b>		PROJECT NO. D-00-3	SCALE 1:100	SHEET 3 of 6	REVISION --
DRAWING TITLE LANDSCAPING DESIGN - HARD WORKS PLAN - UNIT 1		CAD FILE PATH -	PRINT DATE 07/08/2013		DWG NO. <b>LC-101</b>
DRAWN AB	CHECKED JB	APPROVED JB			


**JOSH BYRNE & ASSOCIATES**  
 Environment • Design • Communication  
 phone 08 9433 3721 fax 08 9433 3728  
 suite 10, 16 phillimore street fremantle wa 6160  
 po box 1866, fremantle wa 6959  
 www.joshbyrne.com.au  
 jba@joshbyrne.com.au

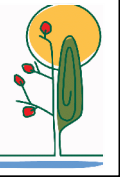

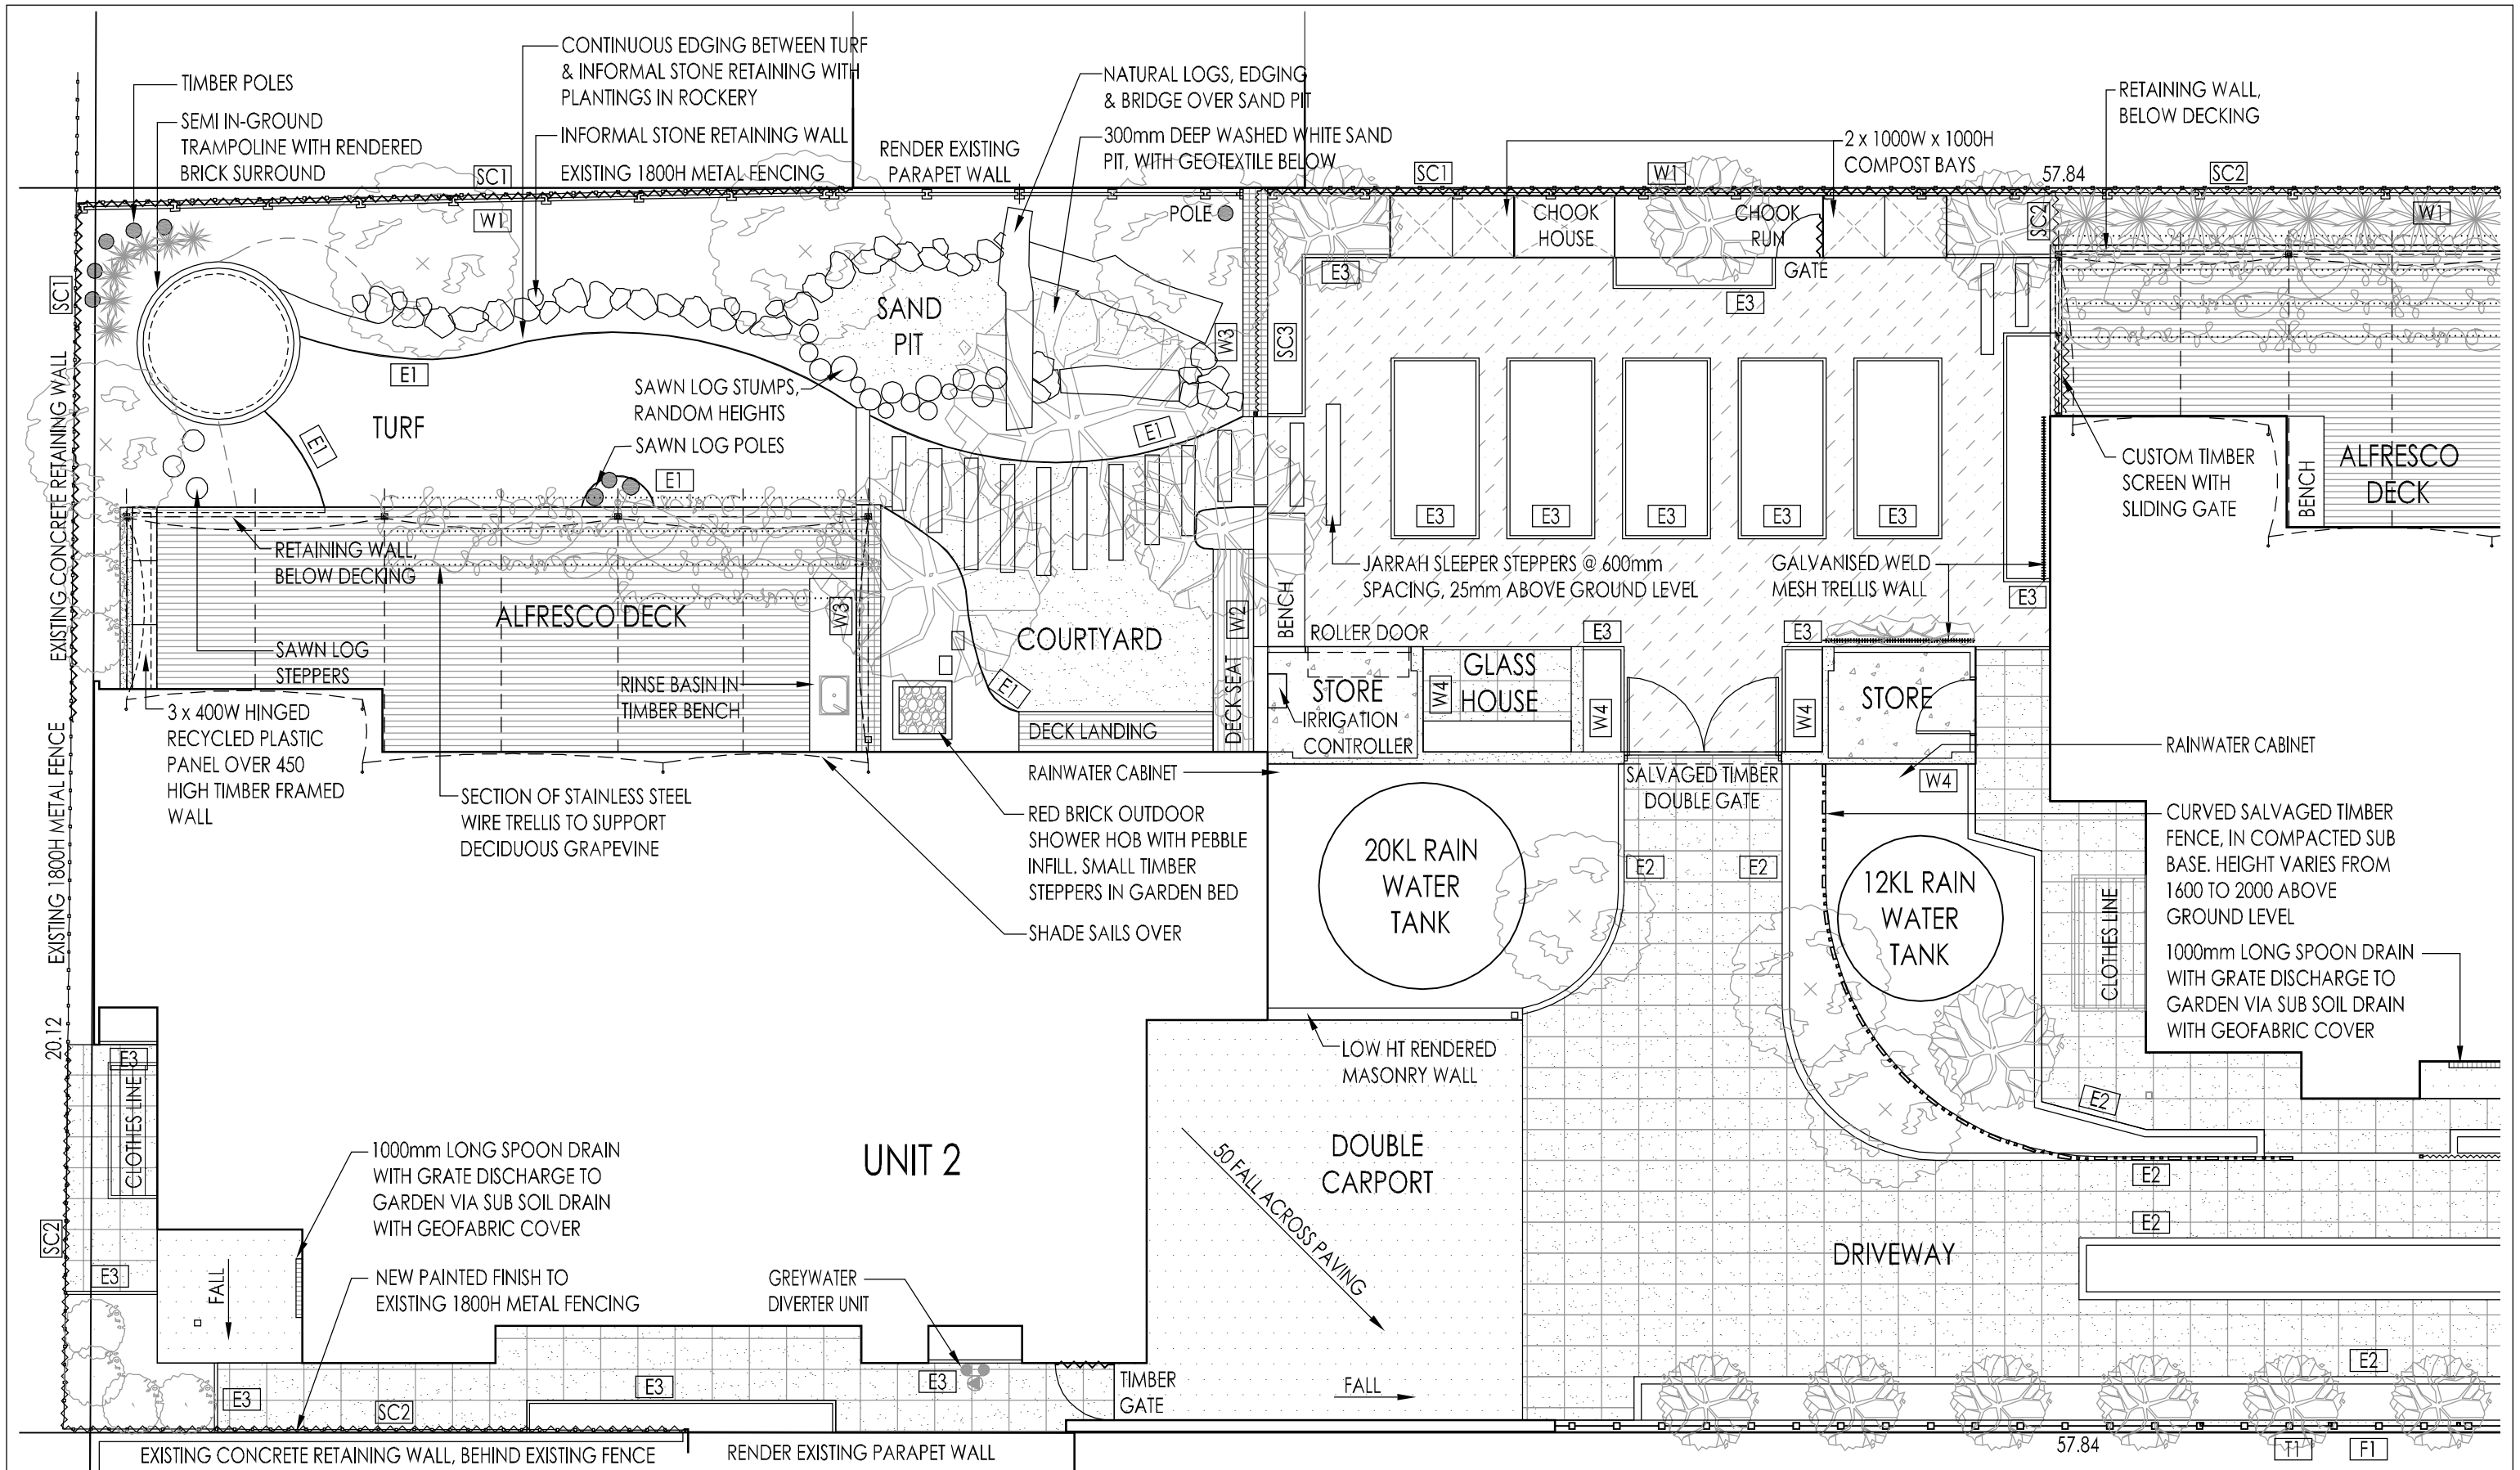

07/08/2013	AS CONSTRUCTED ISSUE	--
DATE	DESCRIPTION	REV

**NOTE:** CHECK ALL DIMENSIONS ON SITE PRIOR TO COMMENCING WORK. WRITTEN DIMENSIONS SHALL TAKE PRECEDENCE. ALL DRAWINGS TO BE READ IN CONJUNCTION WITH MANUFACTURERS AND CONSULTANTS DOCUMENTATION AND SPECIFICATION. REPORT ANY DISCREPANCIES TO LANDSCAPE DESIGNER BEFORE PROCEEDING WITH WORK.  
**COPYRIGHT ©:** THIS DOCUMENT HAS BEEN PREPARED FOR USE BY THE RECEIVING CLIENT ONLY. ALL CONCEPTS, DRAWINGS AND TECHNICAL INFORMATION REMAIN THE PROPERTY OF JOSH BYRNE & ASSOCIATES PTY LTD. THIS DOCUMENT CANNOT BE REPRODUCED OR DISTRIBUTED FOR ANY PURPOSE OTHER THAN FOR CONSTRUCTION PURPOSES OF THE SITE DESCRIBED.

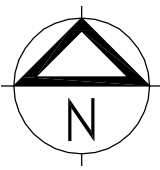


## AS CONSTRUCTED




PROJECT TITLE <b>JOSH'S HOUSE</b>		PROJECT NO. D-00-3	SCALE 1:100	SHEET 4 of 6	REVISION --
DRAWING TITLE LANDSCAPING DESIGN - HARD WORKS PLAN - UNIT 2		CAD FILE PATH -	PRINT DATE 07/08/2013		DWG NO. LC-102
DRAWN AB	CHECKED JB	APPROVED JB			

**JOSH BYRNE & ASSOCIATES**  
 Environment • Design • Communication  
 phone 08 9433 3721 fax 08 9433 3728  
 suite 10, 16 phillimore street fremantle wa 6160  
 po box 1866, fremantle wa 6959  
 www.joshbyrne.com.au  
 jba@joshbyrne.com.au

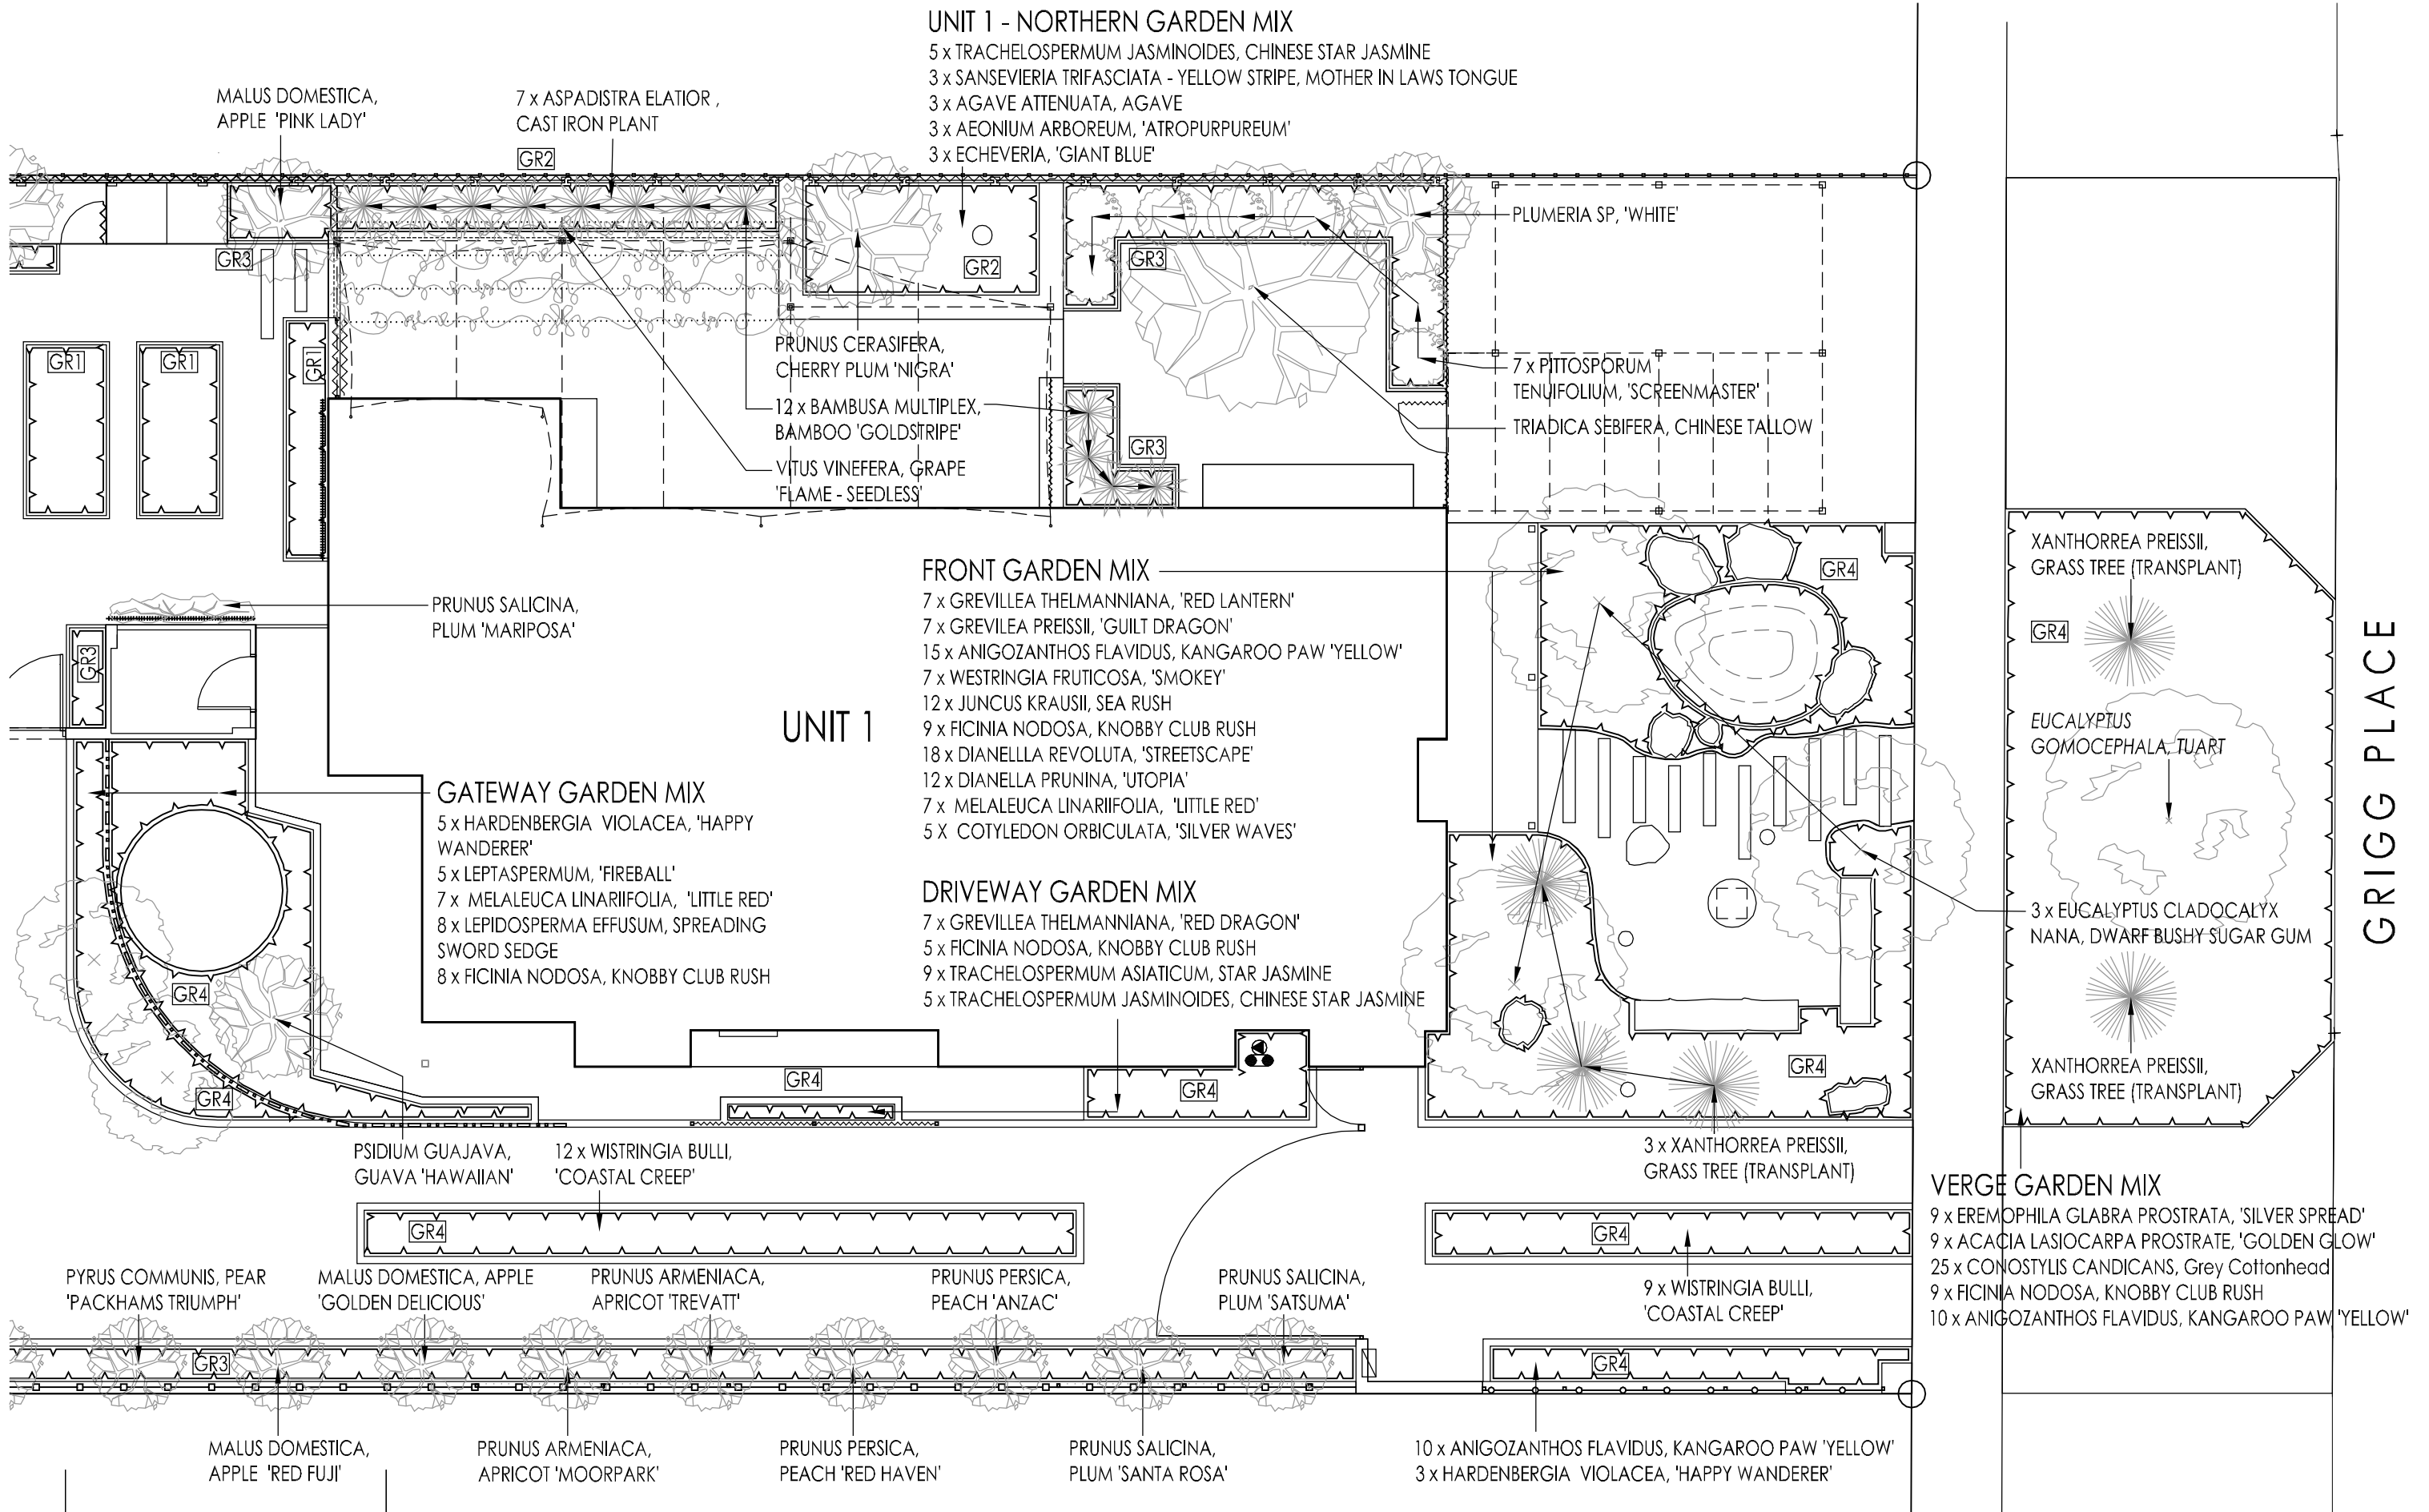

07/08/2013	AS CONSTRUCTED ISSUE	--
DATE	DESCRIPTION	REV


**NOTE:** CHECK ALL DIMENSIONS ON SITE PRIOR TO COMMENCING WORK. WRITTEN DIMENSIONS SHALL TAKE PRECEDENCE. ALL DRAWINGS TO BE READ IN CONJUNCTION WITH MANUFACTURERS AND CONSULTANTS DOCUMENTATION AND SPECIFICATION. REPORT ANY DISCREPANCIES TO LANDSCAPE DESIGNER BEFORE PROCEEDING WITH WORK.  
**COPYRIGHT ©:** THIS DOCUMENT HAS BEEN PREPARED FOR USE BY THE RECEIVING CLIENT ONLY. ALL CONCEPTS, DRAWINGS AND TECHNICAL INFORMATION REMAIN THE PROPERTY OF JOSH BYRNE & ASSOCIATES PTY LTD. THIS DOCUMENT CANNOT BE REPRODUCED OR DISTRIBUTED FOR ANY PURPOSE OTHER THAN FOR CONSTRUCTION PURPOSES OF THE SITE DESCRIBED.

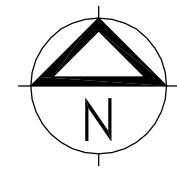

**AS CONSTRUCTED**



PROJECT TITLE <b>JOSH'S HOUSE</b>		PROJECT NO. D-00-3	SCALE 1:100	SHEET 5 of 6	REVISION --
DRAWING TITLE LANDSCAPING DESIGN - SOFT WORKS PLAN - UNIT 1		CAD FILE PATH -	PRINT DATE 07/08/2013		DWG NO. LC-201
DRAWN AB	CHECKED JB	APPROVED JB			
JOSH BYRNE & ASSOCIATES Environment • Design • Communication phone 08 9433 3721 fax 08 9433 3728 suite 10, 16 phillimore street fremantle wa 6160 po box 1866, fremantle wa 6959 www.joshbyrne.com.au jba@joshbyrne.com.au					

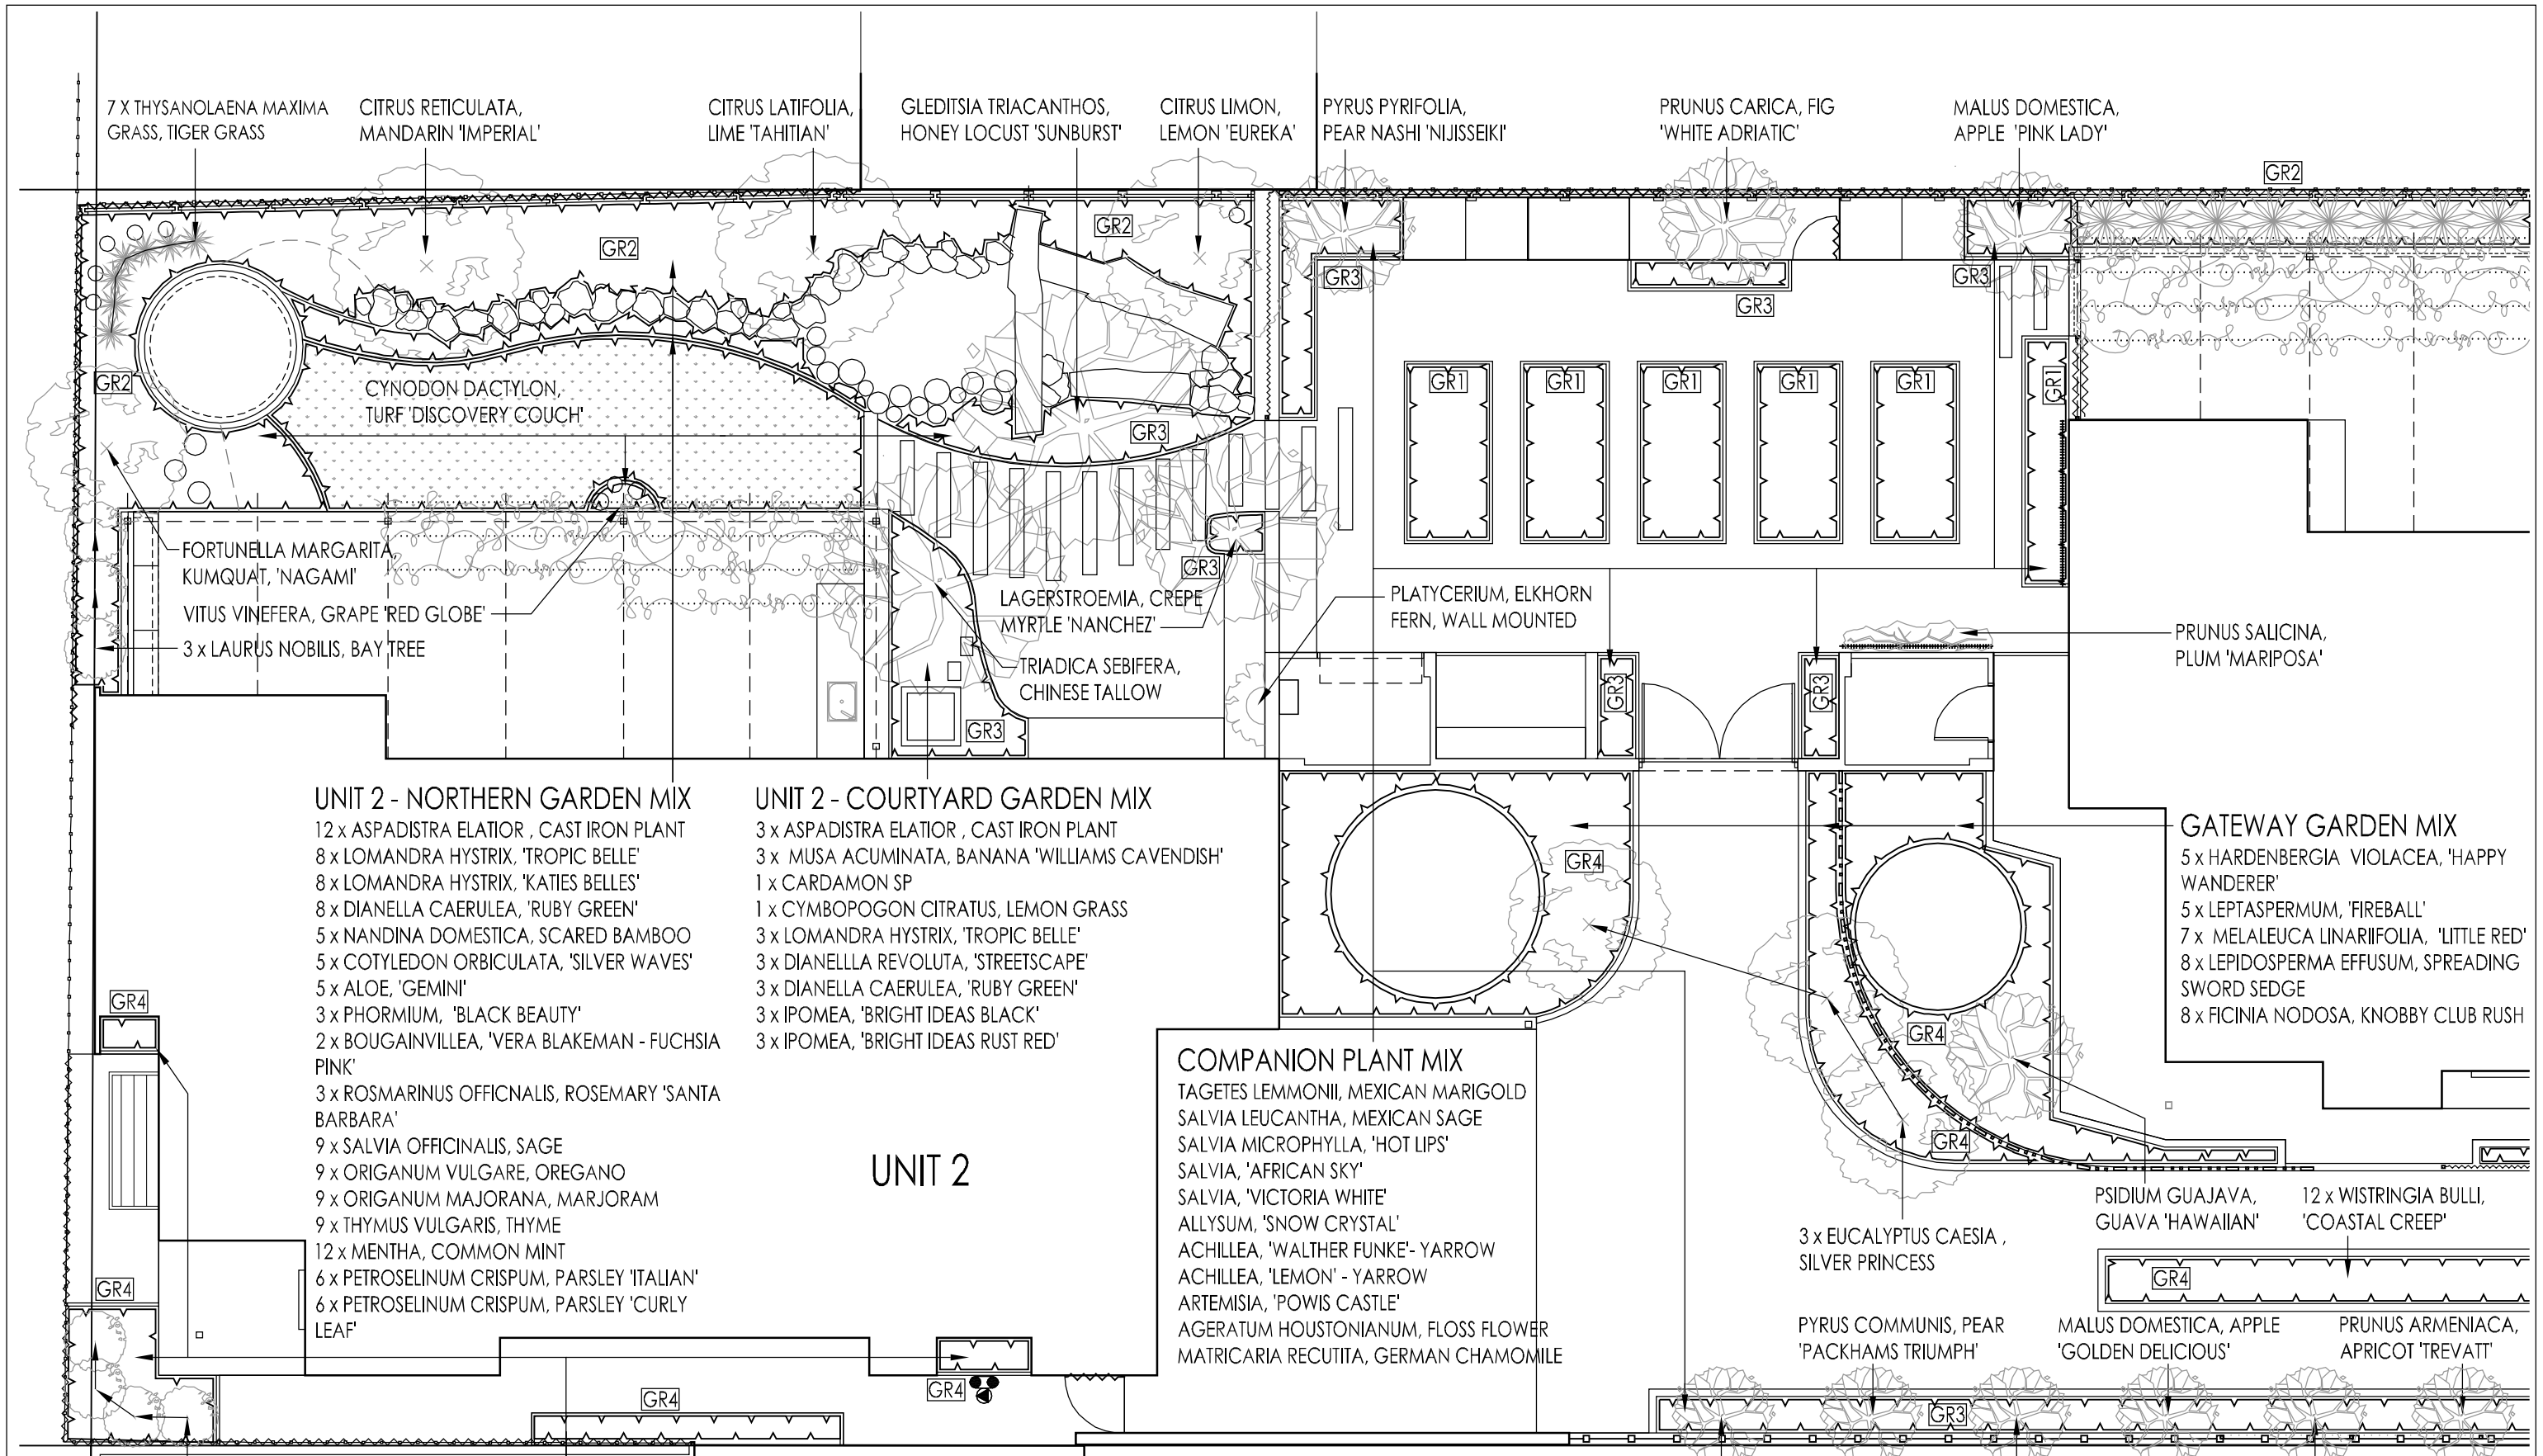

- UNIT 2 - NORTHERN GARDEN MIX**  
 12 x ASPADISTRA ELATIOR, CAST IRON PLANT  
 8 x LOMANDRA HYSTRIX, 'TROPIC BELLE'  
 8 x LOMANDRA HYSTRIX, 'KATIES BELLES'  
 8 x DIANELLA CAERULEA, 'RUBY GREEN'  
 5 x NANDINA DOMESTICA, SCARED BAMBOO  
 5 x COTYLEDON ORBICULATA, 'SILVER WAVES'  
 5 x ALOE, 'GEMINI'  
 3 x PHORMIUM, 'BLACK BEAUTY'  
 2 x BOUGAINVILLEA, 'VERA BLAKEMAN - FUCHSIA PINK'  
 3 x ROSMARINUS OFFICINALIS, ROSEMARY 'SANTA BARBARA'  
 9 x SALVIA OFFICINALIS, SAGE  
 9 x ORIGANUM VULGARE, OREGANO  
 9 x ORIGANUM MAJORANA, MARJORAM  
 9 x THYMUS VULGARIS, THYME  
 12 x MENTHA, COMMON MINT  
 6 x PETROSELINUM CRISPUM, PARSLEY 'ITALIAN'  
 6 x PETROSELINUM CRISPUM, PARSLEY 'CURLY LEAF'

- UNIT 2 - COURTYARD GARDEN MIX**  
 3 x ASPADISTRA ELATIOR, CAST IRON PLANT  
 3 x MUSA ACUMINATA, BANANA 'WILLIAMS CAVENDISH'  
 1 x CARDAMON SP  
 1 x CYMBOPOGON CITRATUS, LEMON GRASS  
 3 x LOMANDRA HYSTRIX, 'TROPIC BELLE'  
 3 x DIANELLA REVOLUTA, 'STREETSCAPE'  
 3 x DIANELLA CAERULEA, 'RUBY GREEN'  
 3 x IPOMEA, 'BRIGHT IDEAS BLACK'  
 3 x IPOMEA, 'BRIGHT IDEAS RUST RED'


- COMPANION PLANT MIX**  
 TAGETES LEMMONII, MEXICAN MARIGOLD  
 SALVIA LEUCANTHA, MEXICAN SAGE  
 SALVIA MICROPHYLLA, 'HOT LIPS'  
 SALVIA, 'AFRICAN SKY'  
 SALVIA, 'VICTORIA WHITE'  
 ALLYSUM, 'SNOW CRYSTAL'  
 YARROW  
 ACHILLEA, 'WALTHER FUNKE'  
 ACHILLEA, 'LEMON'  
 ARTEMISIA, 'POWIS CASTLE'  
 AGERATUM HOUSTONIANUM, FLOSS FLOWER  
 MATRICARIA RECUTITA, GERMAN CHAMOMILE

- GATEWAY GARDEN MIX**  
 5 x HARDENBERGIA VIOLACEA, 'HAPPY WANDERER'  
 5 x LEPTASPERMUM, 'FIREBALL'  
 7 x MELALEUCA LINARIFOLIA, 'LITTLE RED'  
 8 x LEPIDOSPERMA EFFUSUM, SPREADING SWORD SEDGE  
 8 x FICINIA NODOSA, KNOBBY CLUB RUSH

- UNIT 2 - REAR CORNER MIX**  
 13 x TRACHELOSPERMUM ASIATICUM, STAR JASMINE  
 12 x SANSEVIERIA TRIFASCIATA - GREEN STRIPE, MOTHER IN LAWS TONGUE  
 5 x ASPADISTRA ELATIOR, CAST IRON PLANT

07/08/2013	AS CONSTRUCTED ISSUE	--
DATE	DESCRIPTION	REV

**NOTE:** CHECK ALL DIMENSIONS ON SITE PRIOR TO COMMENCING WORK. WRITTEN DIMENSIONS SHALL TAKE PRECEDENCE. ALL DRAWINGS TO BE READ IN CONJUNCTION WITH MANUFACTURERS AND CONSULTANTS DOCUMENTATION AND SPECIFICATION. REPORT ANY DISCREPANCIES TO LANDSCAPE DESIGNER BEFORE PROCEEDING WITH WORK.  
**COPYRIGHT ©:** THIS DOCUMENT HAS BEEN PREPARED FOR USE BY THE RECEIVING CLIENT ONLY. ALL CONCEPTS, DRAWINGS AND TECHNICAL INFORMATION REMAIN THE PROPERTY OF JOSH BYRNE & ASSOCIATES PTY LTD. THIS DOCUMENT CANNOT BE REPRODUCED OR DISTRIBUTED FOR ANY PURPOSE OTHER THAN FOR CONSTRUCTION PURPOSES OF THE SITE DESCRIBED.

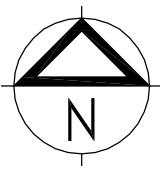

**AS CONSTRUCTED**



PROJECT TITLE <b>JOSH'S HOUSE</b>		PROJECT NO. D-00-3	SCALE 1:100	SHEET 6 of 6	REVISION --
DRAWING TITLE LANDSCAPING DESIGN - SOFT WORKS PLAN - UNIT 2		CAD FILE PATH -	PRINT DATE 07/08/2013		DWG NO. LC-202
DRAWN AB	CHECKED JB	APPROVED JB			

**JOSH BYRNE & ASSOCIATES**  
 Environment • Design • Communication  
 phone 08 9433 3721 fax 08 9433 3728  
 suite 10, 16 phillimore street fremantle wa 6160  
 po box 1866, fremantle wa 6959  
 www.joshbyrne.com.au  
 jba@joshbyrne.com.au